

**SCDHEC OFFICE OF OCEAN AND COASTAL RESOURCE MANAGEMENT
PERMIT APPLICATION PUBLIC NOTICE**

October 30, 2009

Permit Number: OCRM-09-926-L
Permit ID: 68300

The SCDHEC Office of Ocean and Coastal Resource Management has received an application for a permit for the alteration of a critical area. This application was submitted pursuant to the Coastal Zone Management Act (Act 123) of the 1977 South Carolina General Assembly. The application, in brief, is described as follows:

APPLICANT: Brenda P Batten
C/o Atlantic Marine Construction Co Inc
372 County Shed Road
Beaufort SC 29906

LOCATION: On and adjacent to May River at 14 Nanny Cove Court, Bluffton, Beaufort County, South Carolina. TMS#: R600-039-00C-0006-0000.

WORK: The work as proposed and shown on the attached plans consists of making modifications and additions to an existing private dock. Specifically, the existing structure consists of a 3'x45' walkway with handrails leading to a 14'x14' covered fixed pierhead. Channelward of the covered fixed pierhead is a 3'x10' walkway leading to a 14'x14' uncovered fixed pierhead. The applicant proposes to convert the two (2) 14'x14' fixed pierheads and 3'x10' walkway into a 14'x38' covered fixed pierhead with a 2'x5' counter and sink to the floodside. Also proposed is the addition of a 12'x13' four-pile boatlift to the ebbside of the existing 9'x40' floating dock. The purpose of the activity is for the applicant's private recreational use.

This public notice is being distributed to all known interested persons and agencies to assist in developing facts on which a decision by OCRM can be based. Comments concerning the proposed work should be submitted in writing, setting forth sufficient detail to furnish a clear understanding of the reasons for support or opposition.

The decision to issue or deny a permit will be based on the individual merits of the application, the policies specified in the South Carolina Coastal Zone Management Act, and the considerations outlined in the State of South Carolina Coastal Zone Management Program. Interested parties who wish to be notified of final permit action must notify OCRM in writing of this request.

To assure review by OCRM, comments regarding this application must be received by OCRM on or before November 14, 2009. For further information please contact the project manager for this activity, Kathleen Lamaker at 843-846-9400.

PLEASE REPLY TO:
SCDHEC OFFICE OF OCEAN AND COASTAL RESOURCE MANAGEMENT
104 Parker Drive
Beaufort, South Carolina 29906

Please refer to P/N# OCRM-09-926-L


K. Lamaker
Kathleen Lamaker, Wetland Section Project Manager



GASQUE & ASSOCIATES INC.
LAND SURVEYORS & PLANNERS

28 PROFESSIONAL VILLAGE CIRCLE, BEAUFORT, S.C.
P.O. BOX 1363, BEAUFORT, S.C.
PHONE (843) 522-1788

SHEET # 1 OF 3

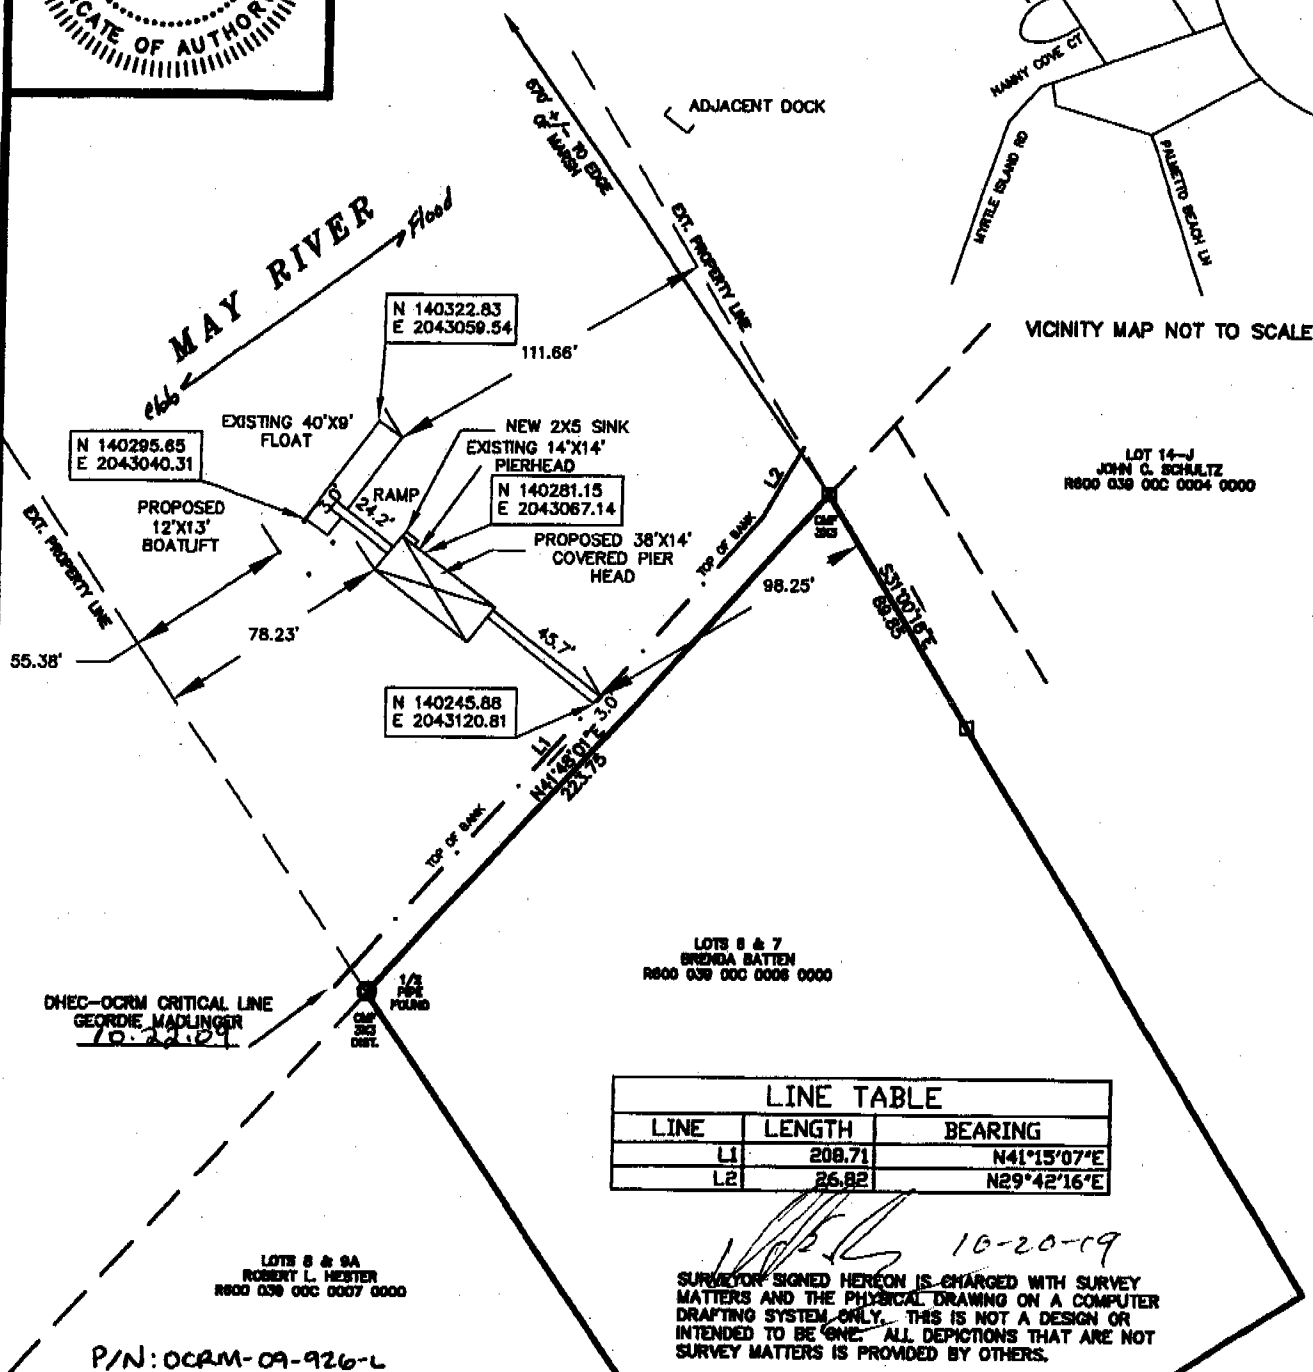

- ADJACENT PROPERTY OWNERS:
- HESTER ROBERT LEE TRUSTEE
8 NANNY COVE CT
BLUFFTON, SC 29910
R600 039 000 0007 0000
LOTS 8 & 9A
 - SCHULTZ JOHN C JR
1718 PEACHTREE ST NW
SUITE 175 ATLANTA, GA 30309
R600 039 000 0004 0000
LOT 14-J

0 30 60 120



SCALE: 1"=60'

BRENDA BATTEN
14 NANNY COVE RD
BLUFFTON, SC 29910
LOTS 5,6,& 7
R600 039 000 0006 0000

DOCK ASBUILT FOR PERMIT

IN: MAY RIVER

AT: PALMETTO BEACH

COUNTY OF: BEAUFORT
STATE: SOUTH CAROLINA

JOB# 38675 FB790/JEP DSGN5 DATE: 10/19/09




GASQUE & ASSOCIATES INC. LAND SURVEYORS & PLANNERS

28 PROFESSIONAL VILLAGE CIRCLE, BEAUFORT, S.C.
P.O. BOX 1363, BEAUFORT, S.C.
PHONE (843) 522-1798

SHEET # 2 OF 3


MAY RIVER

PLAN VIEW

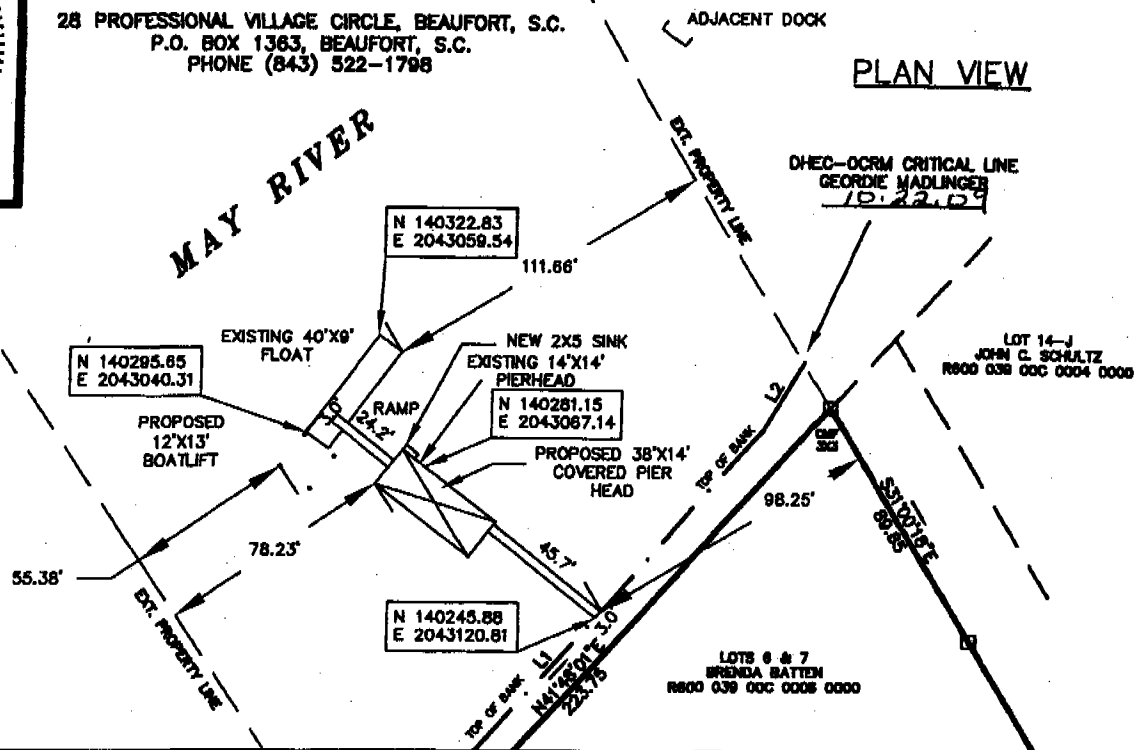

NOT TO SCALE

PROFILE VIEW

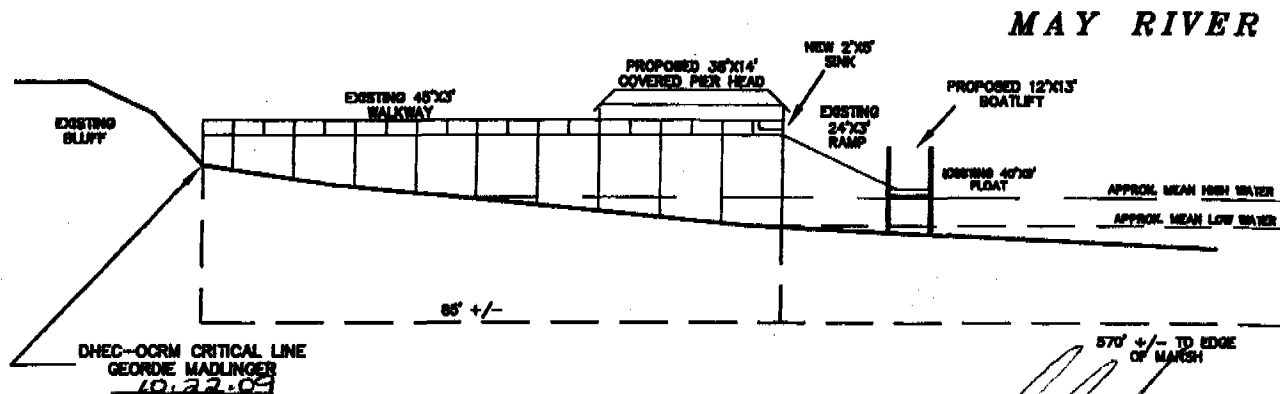

NOT TO SCALE

P/N: OCRM-09-926-L

ADJACENT PROPERTY OWNERS:

1. HESTER ROBERT LEE TRUSTEE
8 NANNY COVE CT
BLUFFTON, SC 29910
R600 039 00C 0007 0000
LOTS 8 & 9A
2. SCHULTZ JOHN C JR
1718 PEACHTREE ST NW
SUITE 175 ATLANTA, GA 30309
R600 039 00C 0004 0000
LOT 14-J

BRENDA BATTEN
14 NANNY COVE RD
BLUFFTON, SC 29910
LOTS 5,6,& 7
R600 039 00C 0006 0000

DOCK ASBUILT FOR PERMIT

IN: MAY RIVER
AT: PALMETTO BEACH
COUNTY OF: BEAUFORT
STATE: SOUTH CAROLINA

JOB# 36875 FB790/JEP DSGN5 DATE: 10/19/09




GASQUE & ASSOCIATES INC.
LAND SURVEYORS & PLANNERS


28 PROFESSIONAL VILLAGE CIRCLE, BEAUFORT, S.C.
P.O. BOX 1383, BEAUFORT, S.C.
PHONE (843) 522-1788

SHEET # 3 OF 3

MAY RIVER

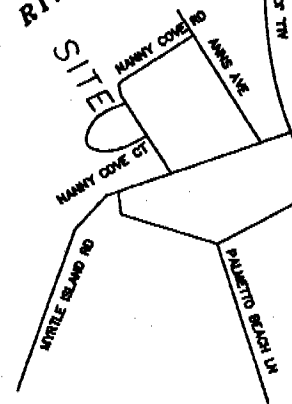

VICINITY MAP NOT TO SCALE

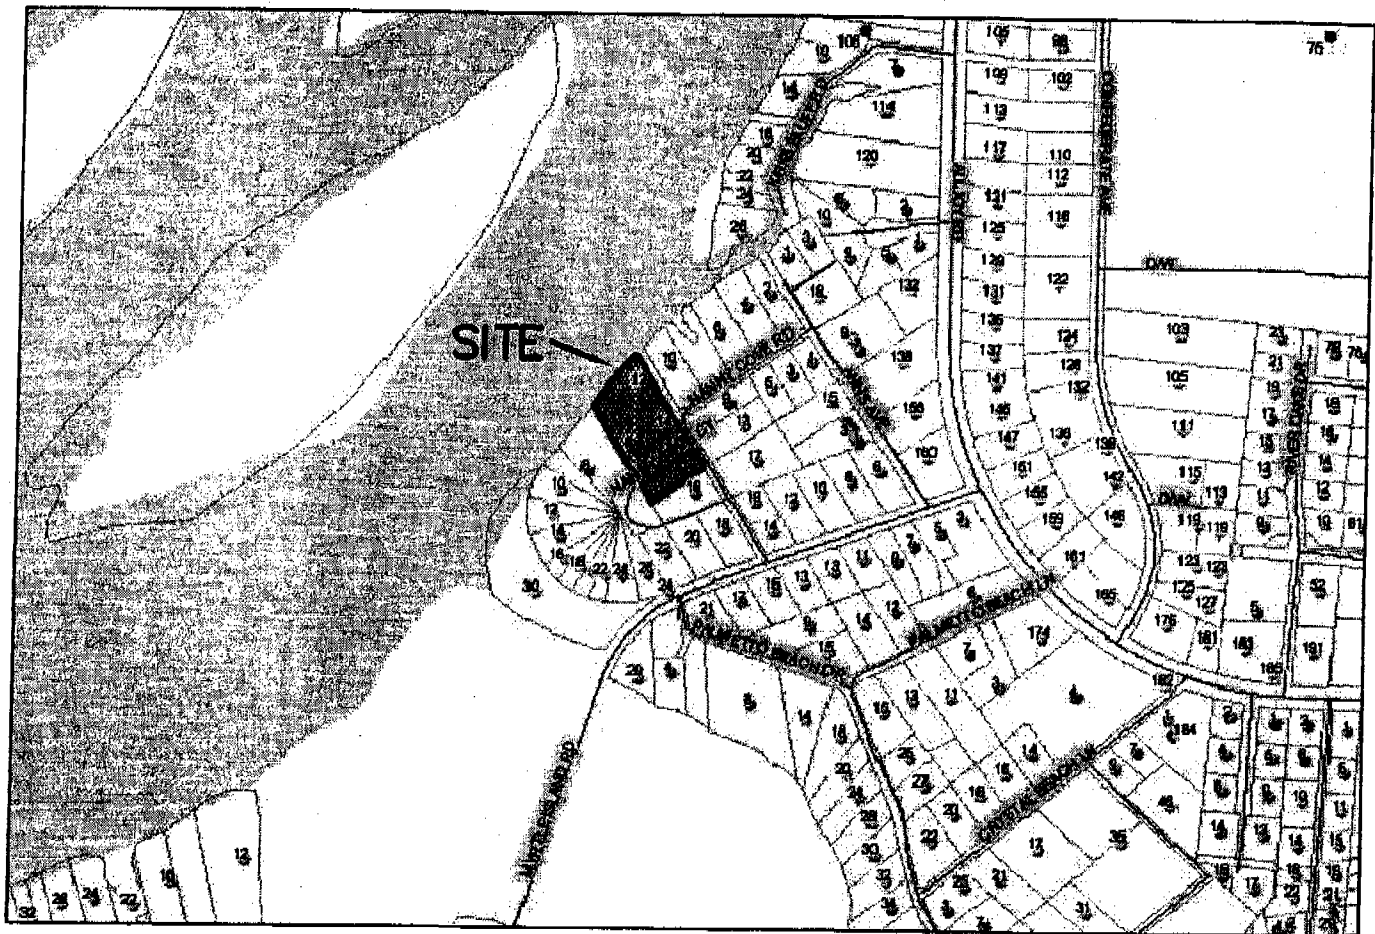

NOT TO SCALE

P/N: OCRM-09-926-L

ADJACENT PROPERTY OWNERS:

1. HESTER ROBERT LEE TRUSTEE
8 NANNY COVE CT
BLUFFTON, SC 29910
R600 039 00C 0007 0000
LOTS 8 & 9A
2. SCHULTZ JOHN C JR
1718 PEACHTREE ST NW
SUITE 175 ATLANTA, GA 30309
R600 039 00C 0004 0000
LOT 14-J

BRENDA BATTEN
14 NANNY COVE RD
BLUFFTON, SC 29910
LOTS 5, 6, & 7
R600 039 00C 0006 0000

DOCK ASBUILT FOR PERMIT

IN: MAY RIVER

AT: PALMETTO BEACH

COUNTY OF: BEAUFORT
STATE: SOUTH CAROLINA

JOB# 36675 FB790/JEP DSGN5 DATE: 10/5/09